
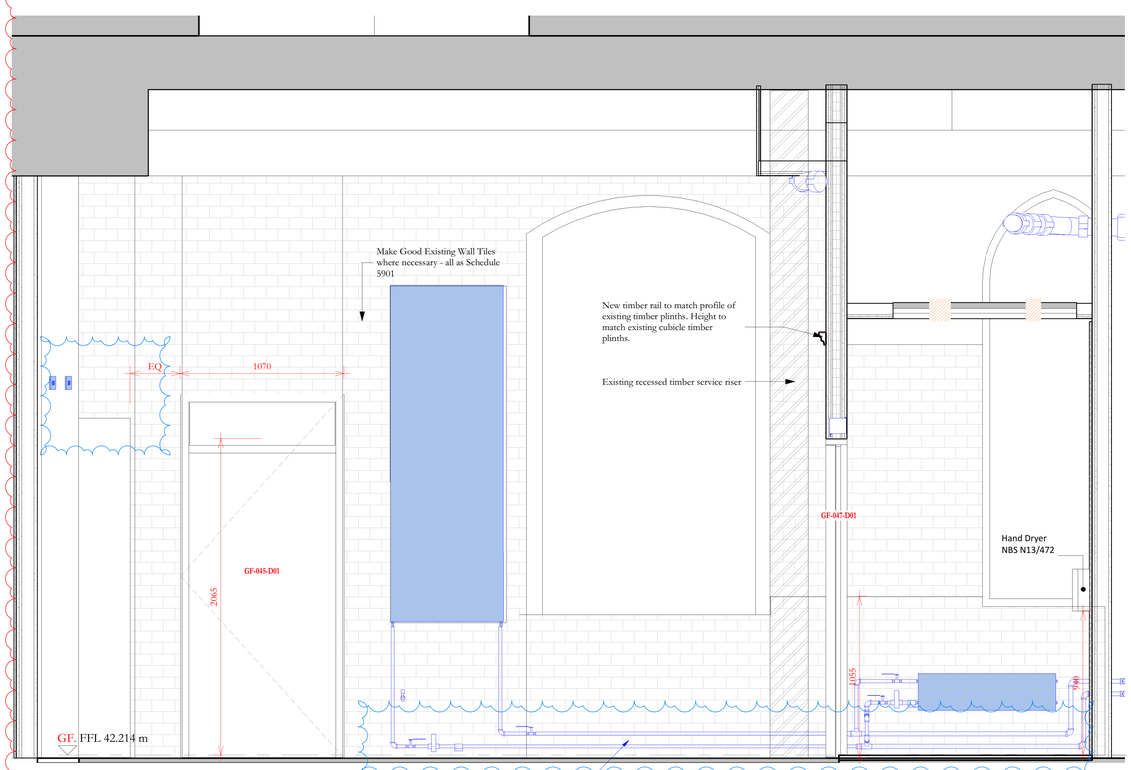


L Ground Floor Heritage Toilets El-L

Scale: 1 : 20


MEP shown in blue is indicative only, not to be used for setting out. Refer to Arup information for details.

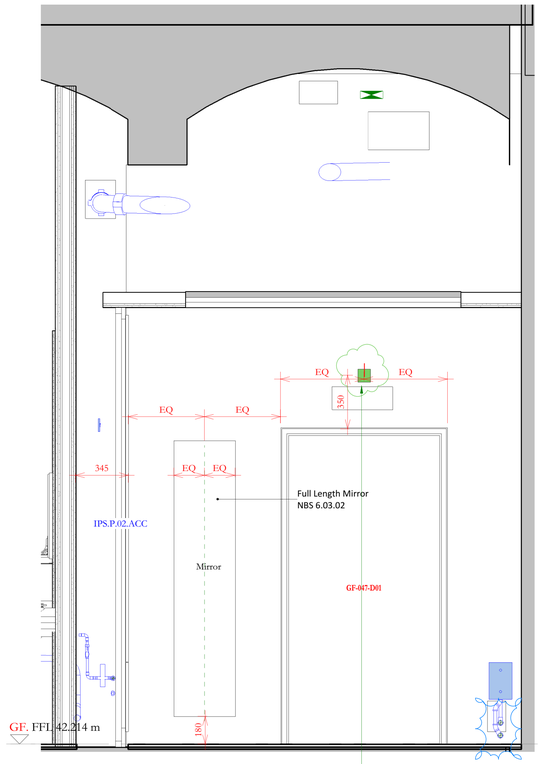

M GF-047 Accessible WC El-M

Scale: 1 : 20


Contractor to install MEP equipment as per the architectural intent, shown in green, this is the coordinated design. Refer to Arup information for details.

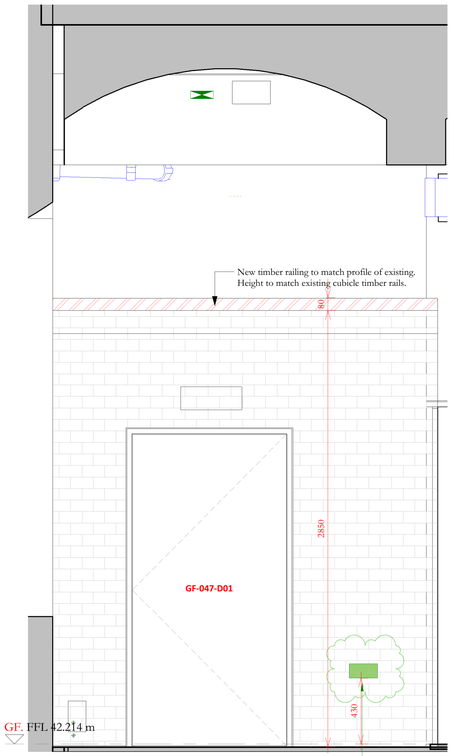

N GF-C02h Corridor El-N


Scale: 1 : 20

Contractor to install MEP equipment as per the architectural intent, shown in green, this is the coordinated design. Refer to Arup information for details.

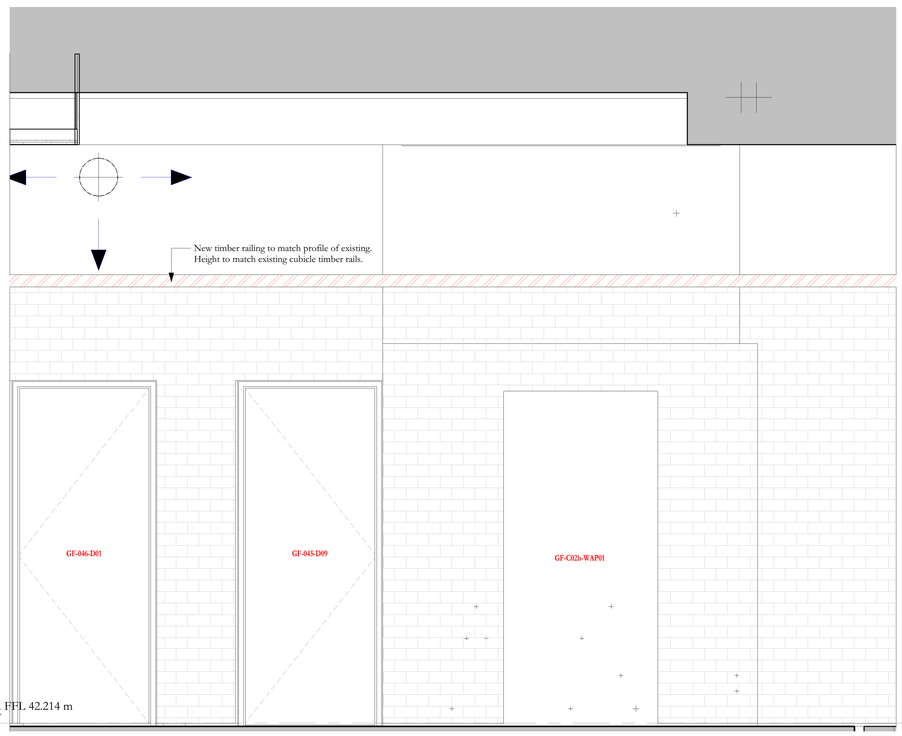


O GF-C02h Corridor El-O

Scale: 1 : 20

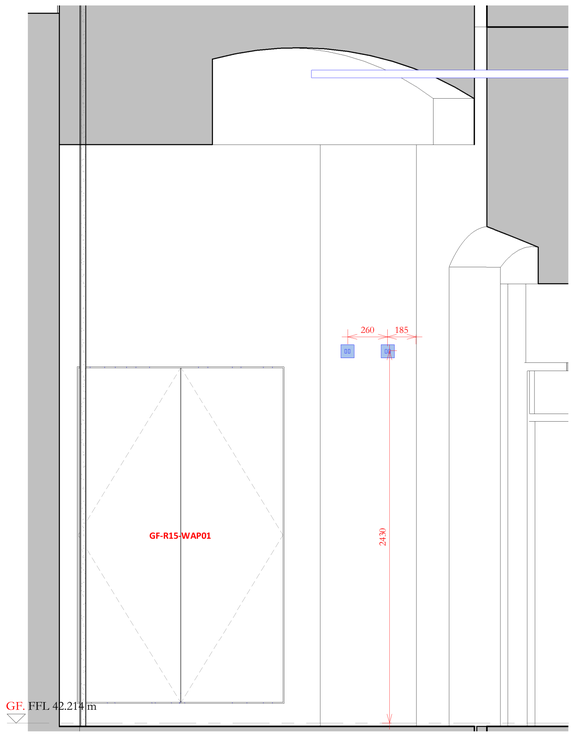

P GF-C02h Corridor El-P

Scale: 1 : 20

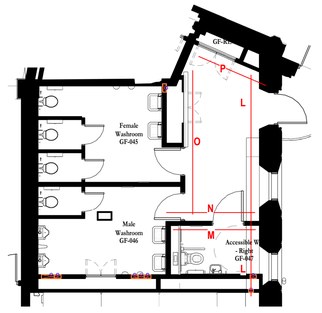

Key Plan - Heritage Toiliets

1 : 100

Scale Bars to be used as guidance only - refer to sheet size below

1:100	mm	1000	3000	5000	7000		
1:200	mm	5000	8000	12000	16000		
1:500	M	5	15	25	35		
1:1250	M	10	30	50	70	90	

Notes:

Drawings are based on survey data and may not accurately represent what is physically present.
Do not scale from this drawing. All dimensions are to be verified on site before proceeding with the work.
All dimensions are in millimeters unless noted otherwise.
Purcell shall be notified in writing of any discrepancies.

Key Plan

General Notes:


1. This drawing is for Construction and shall be read in conjunction with all other relevant drawings and documents.
2. Information is based on Revit model:-
   OTH-PUR-ZZ-ZZ-M3D-A-0009
3. Setting out to be determined in advance of installation and agreed with Architect on site. For tiling installation, including setting out, movement joints, etc. refer to NBS Specification M40 OTH-PUR-TH-ZZ-SPE-A-5924. In particular, allow for movement joints to perimeter of full room, to vertical corners and at thresholds between different floor finishes.
4. All proprietary products to be used strictly in accordance with the manufacturer's specification and details.
5. Please refer to drawings OTH-PUR-TH-ZZ-DWG-A-8147 to 8151 for core detailed areas.
6. All drawings to be read in conjunction with the relevant NBS specifications:
   M10 - OTH-PUR-TH-ZZ-SPE-A-5918
   M40 - OTH-PUR-TH-ZZ-SPE-A-5924
   M41 - OTH-PUR-TH-ZZ-SPE-A-5930
7. For repairs to thresholds & existing fabric refer to Internal Repair Schedules.
8. This drawing is to be referred to for tiling package only.

PRINCIPLES

1. Dado panel made up of equal height courses in a random bond to minimise number of cut tiles.
2. Full tiles to be set from edges or ends of walls with cut tiles lost in the middle of panes.

Blue linework indicates Arup MEP coordination model:
OTH-ARU-TH-22-M3D-B-001 (rev: 04/07/25)

Green linework indicates architectural intent and setting out for wall placed electrical information. Green clouds indicate intended architectural placement. Refer to Arup information for details.

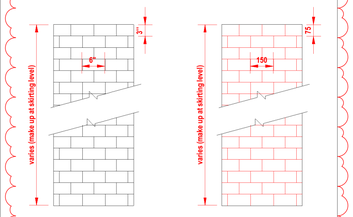

Heritage WC Wall Tiling - Existing
Existing cream 6"x3" Victorian tile.

Heritage WC Wall Tiling - Proposed
New 150x75 'Victorian White' wall tiling to match existing colour and setting out. Refer to M40/113 in OTH-PUR-TH-ZZ-SPE-A-5924

Heritage Wall Tiling

1 : 20

ISSUE	DATE	APPROVED	DRAWN	DESCRIPTION
03	04/07/2025	AD	LT	Issue for Construction
02	21/10/2022	MS	JRC	Minor design amendments to tiling.
01	05/10/2022	MS	JRC	Updated to Lendlease comment
-	03/03/2022	AB	TJC	First Issue

OUR TOWN HALL PROJECT

PURCELL

Project Office, Room 308, Town Hall, MANCHESTER M60 2L1
+44 (0) 7970 097 432
www.purcelluk.com

PROJECT STATUS	RIBA STAGE 5
CLIENT	Manchester City Council
PROJECT	OUR TOWN HALL
DRAWING TITLE	GF-045/046/047 & GF-C02h Heritage Toilets Tiling Elevations 4/4
SIZE & SCALE	A1: As indicated
DRAWING STATUS	FOR CONSTRUCTION
JOB NUMBER	236959
DRAWING NO.	OTH-PUR-TH-GF-DWG-A-8264
REV	03

© PURCELL 2019. PURCELL ® IS THE TRADING NAME OF PURCELL ARCHITECTURE LTD.

04/07/2025 14:30:46