
Notes

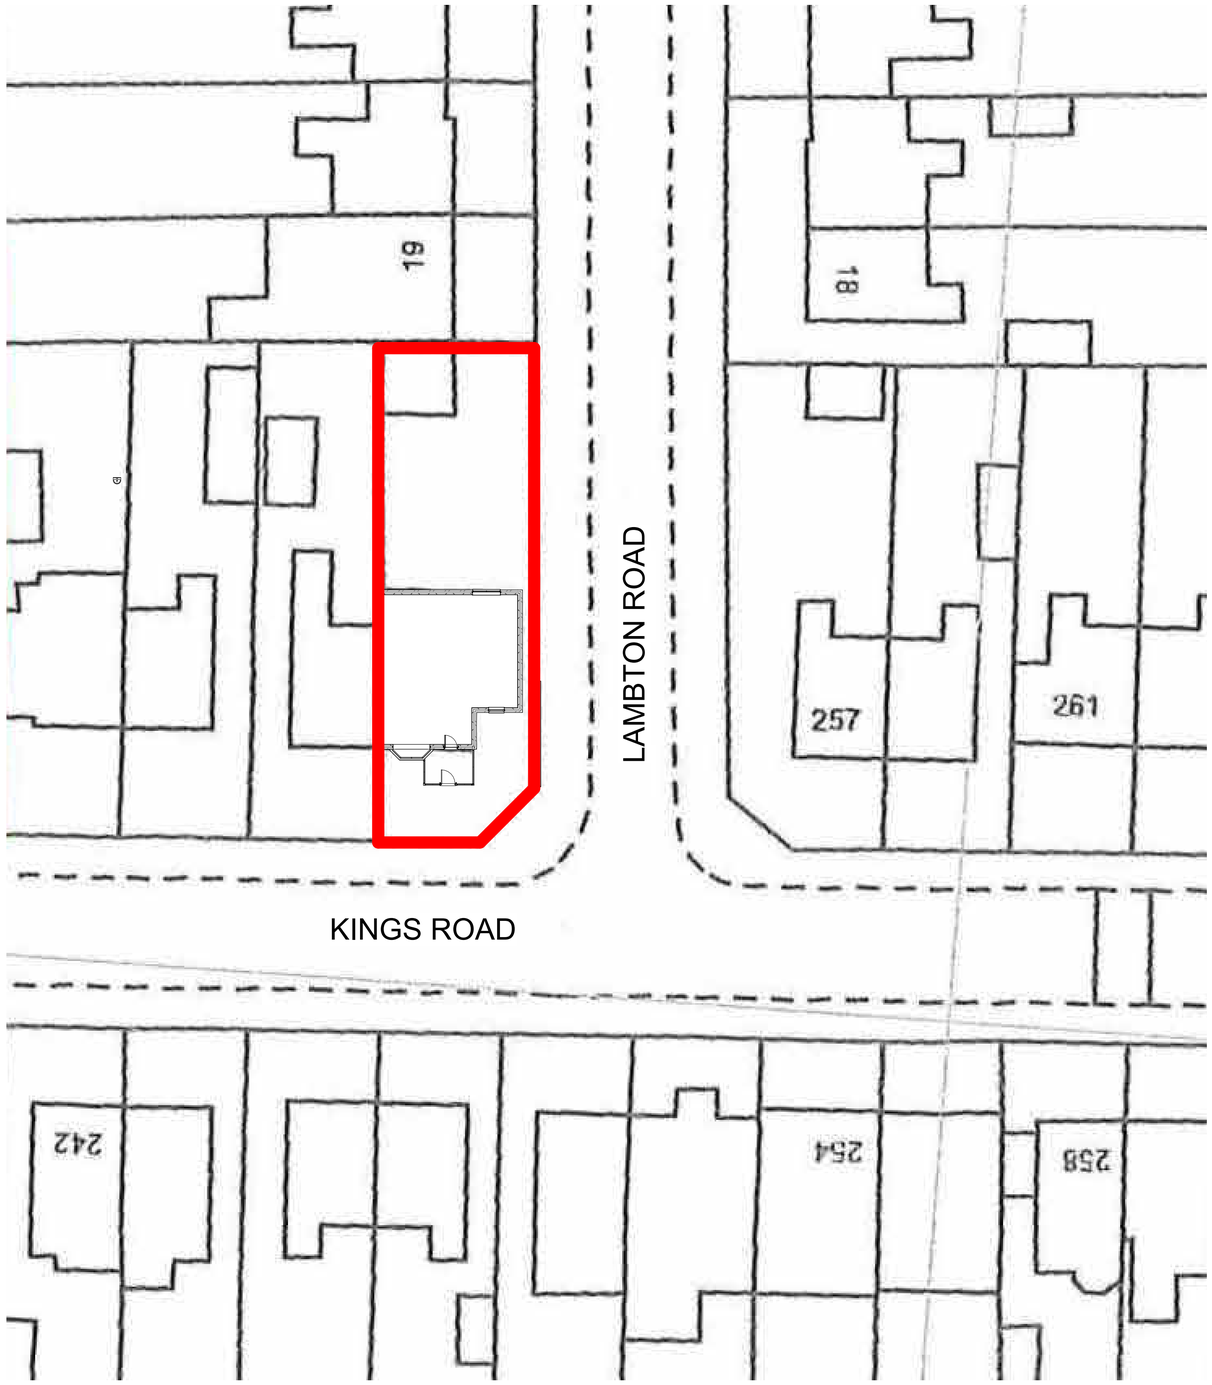

2 SITE PLAN
1 : 200

RED LINE INDICATING SITE BOUNDARY
255 KINGS ROAD, CHORLTON,
MANCHESTER, M21 0XG

Rev	Description	Date	Dr by	App by
original by: NK		date created: 01/09/26		approved by: NK

NK Architectural
Enquiries@nkarchitectural.co.uk
0161 818 4727
www.NKARCHITRCTURAL.co.uk

client name: OWNER

project: 255 KINGS ROAD, CHORLTON, MANCHESTER, M21 0XG

drawing: EXISTING AS BUILT SITE PLAN

computer file	plot date
C:\Users\NKARC07\Dropbox\NKARC\255 Kings Road Chorlton M21 0XJ\255 Kings Road Chorlton M21 0XJ.rvt	
project number: 2026.0042.2231	scale: As indicated @A1
drawing number: A105	rev: / issue status:

This drawing is to be read in conjunction with all related drawings. All dimensions must be checked and verified on site before commencing any work or producing shop drawings. The originator should be notified immediately of any discrepancy.
This drawing is copyright and remains the property of NK Architectural.