

DISCLAIMER OF WARRANTY: The data supplied by us, whether asserted or not, is the sole property of Hall Conservation Ltd and is subject to copyright. Hall Conservation Ltd makes no warranties, express or implied, as to the accuracy of the data supplied and shall not be liable for any direct or indirect, however caused, and resulting in any way by use of the supplied data is the full and final responsibility of the user.

COPYRIGHT: All rights are reserved. No part of this publication may be reproduced, stored in a retrieval system, or transmitted in any form or by any means, without the prior written permission of Hall Conservation Ltd.


Rev	Date	Issue
P01	24/05/2023	Issued for design review
P02	09/06/2023	Issued for design review
P03	20/11/2023	Updated after samples

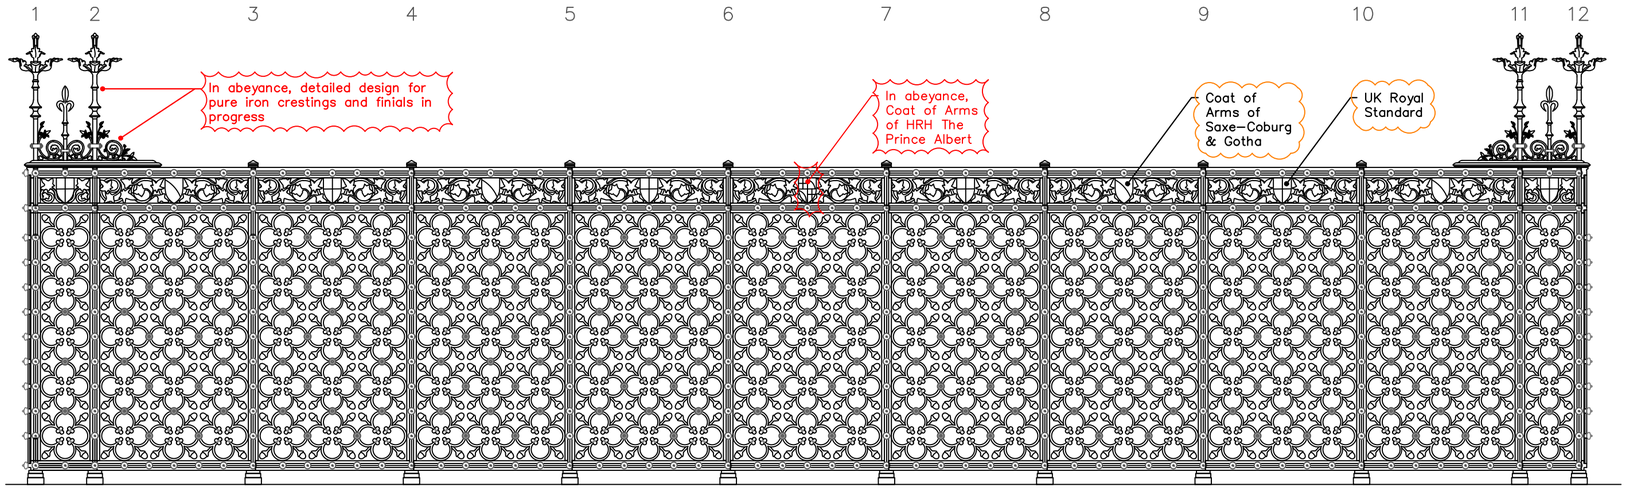

TYPICAL ELEVATION OF PROPOSED RAILINGS 1:20 @ A2

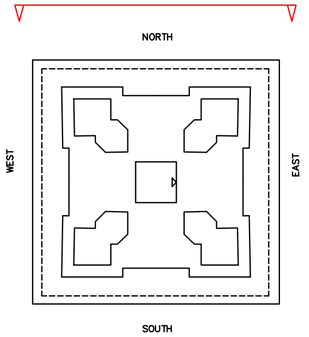


KEY PLAN - NTS @ A2

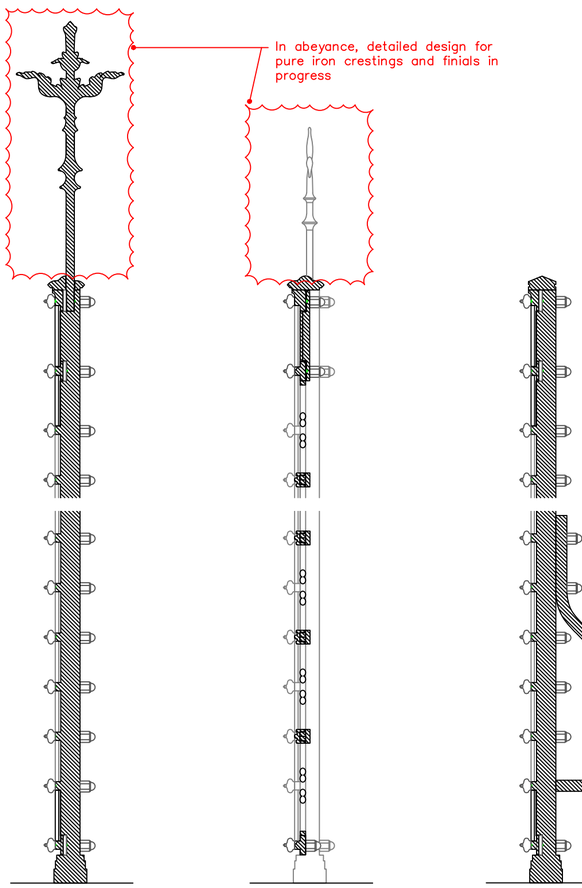


SECTION A 1:10 @ A2


SECTION B 1:10 @ A2

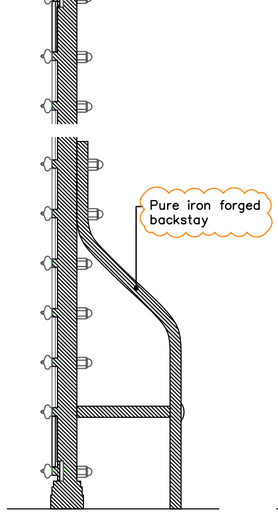

SECTION C 1:10 @ A2

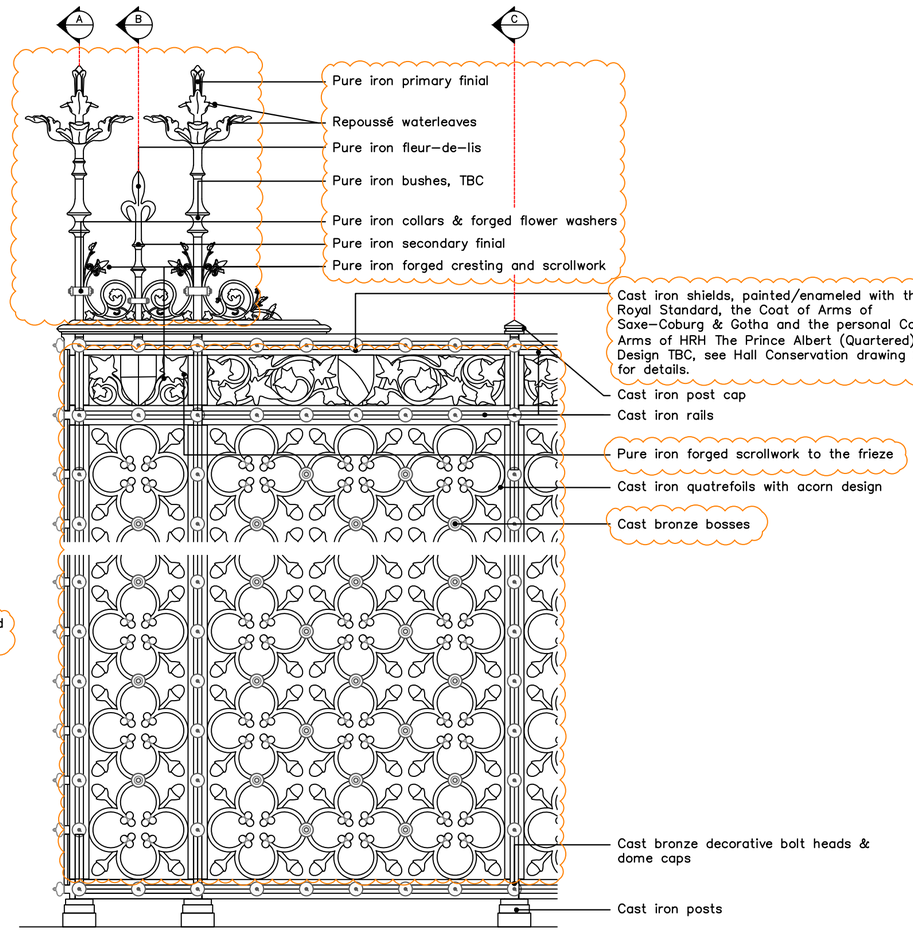

PART ELEVATION OF PROPOSED RAILINGS 1:10 @ A2

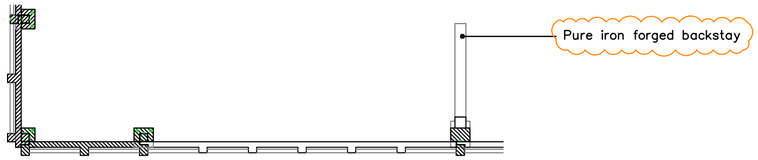

PARTIAL PLAN OF PROPOSED RAILINGS 1:10 @ A2

GENERAL NOTES:
1. All dimensions in mm unless specified.
2. All material to be ductile cast iron or forged pure iron unless specified otherwise.
3. Structure to be painted/coated in selected colour TBC.
4. Fixing holes to be drilled and tapped after casting.

KEY:
Dimples (shown in green) to be cast into the structure to locate fixing points.

ALBERT MEMORIAL RAILINGS General Arrangement

HALL CONSERVATION LTD
EXPERTS IN CONSERVATION AND RESTORATION
www.hallconservation.com 0208 855 8567

Project	Manchester Town Hall
Title	Albert Memorial Railings General Arrangement
Document No.	OTH-HCT-EE-ES-DWG-X-0001
Status	S3 (Suitable for Review & Comment)
Revision	P03
Document Type	DWG
Date: 20/11/2023	Drawn: NY — Scale: VAR @ A2