A1

Lendlease

Document Review


Lendlease document received on:

1. Accepted
2. Accepted with comments
3. Rejected

Lendlease Checked by Jia Wen Lee

Date: 11/12/2019

Review is for general conformance to the design intent, but does not mean acceptance of dimensions, details, size or weights; nor does it relieve the designer from responsibilities for errors, omissions and/or compliance with obligations and/or responsibilities of the contract.

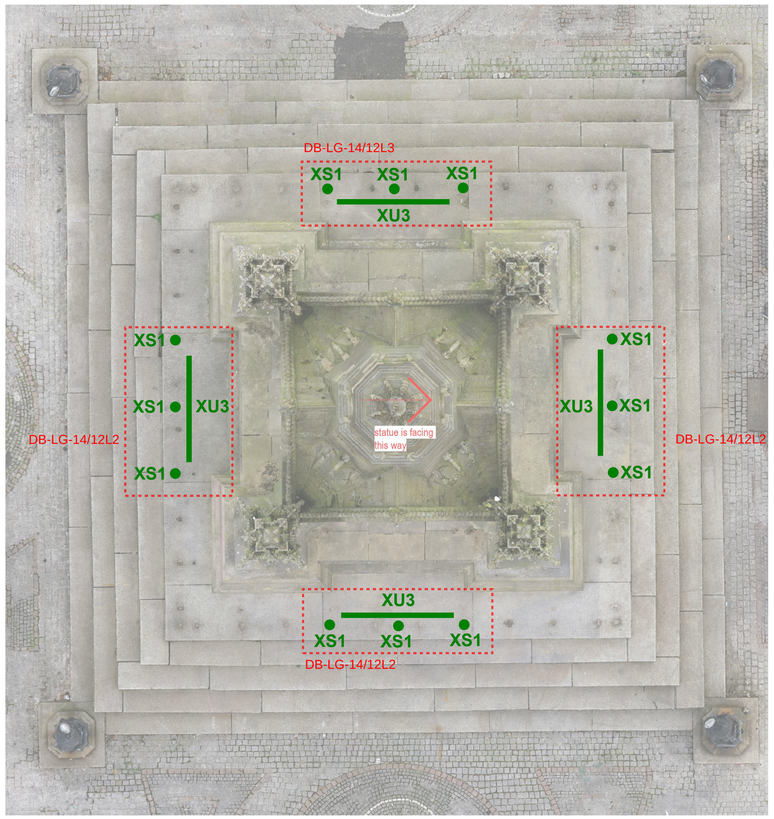

1. Albert Memorial - Plan View



2. Albert Memorial - South Elevation

Notes

1. This drawing shall be read in conjunction with all other relevant drawings and documents.

2. This drawing is based upon Purcell drawing OTH-PUR-EE-ZZ-DWG-A-7101 received 01.10.19.

3. The mounting locations are indicative - with exact locations to be confirmed following markup.

4. Refer to luminaire datasheets for proposed luminaires. The specific luminaire optics will be confirmed on completion of the mock-up works.

5. The specific mounting arrangements to the railings and finish of luminaire to be confirmed by Purcell.

6. Drivers for spotlights to be mounted remotely in IP67 rated enclosures within access chambers.

7. Conduits serving luminaires to be discretely routed within the build-up of the steps, linking from the base of the adjacent perimeter lighting column to the XU3 luminaire and railings.

8. Cabling serving the XS1 luminaires to be discretely routed through the structure of the railings.

9. The railings will be discretely bonded to earth for safety reasons in accordance with BS 7671.

Legend

- Linear LED RGBW up-light, surface mounted to plinth
- LED RGBW spotlight, mounted to railing

Rev	Date	By	Chkd	Appd
P01	04/10/19	AD	LB	TW

Work Stage 4 Issue

ARUP

6th Floor 3 Piccadilly Place
Manchester M1 3BN
Tel +44(0)161 228 2231 Fax +44(0)20 7580 3924
www.arup.com

OUR TOWN HALL PROJECT

Client
Manchester City Council

Project Title
Our Town Hall - Manchester

Drawing Title
Albert Memorial Lighting

Scale at A1
NTS

Role
Lighting

Suitability
D2 - Suitable for tender

Arup Job No
256650-00

Rev
P01

Name
OTH-ARU-EE-ES-DWG-E-15402

12/05/2017 13:44:11

Do not scale

© Arup