ALL DIMENSIONS TO BE CHECKED ON SITE BY BUILDER

DRAWINGS TO BE READ IN CONJUCTION WITH
STRUCTURAL ENGINEER´S DETAILS AND PLANS
SEE GENERAL NOTES FOR FURTHER INFORMATION


SCALE
0 5m 10m

Client: Mr Moniruz Zaman


Project: 194 Hamilton Rd
M13 0PX
Retrospective application for alterations to rear fenestration and modifications to the boundary wall

Proposed Floor Plans
Scale - 1:100


Do not scale from this drawing. All information should be checked by the contractor on site before commencing work. Any discreprencies should be reported to the designer immediately. All rights are reserved and are not transferable. Unathorised reproductions of this drawing are not permitted.

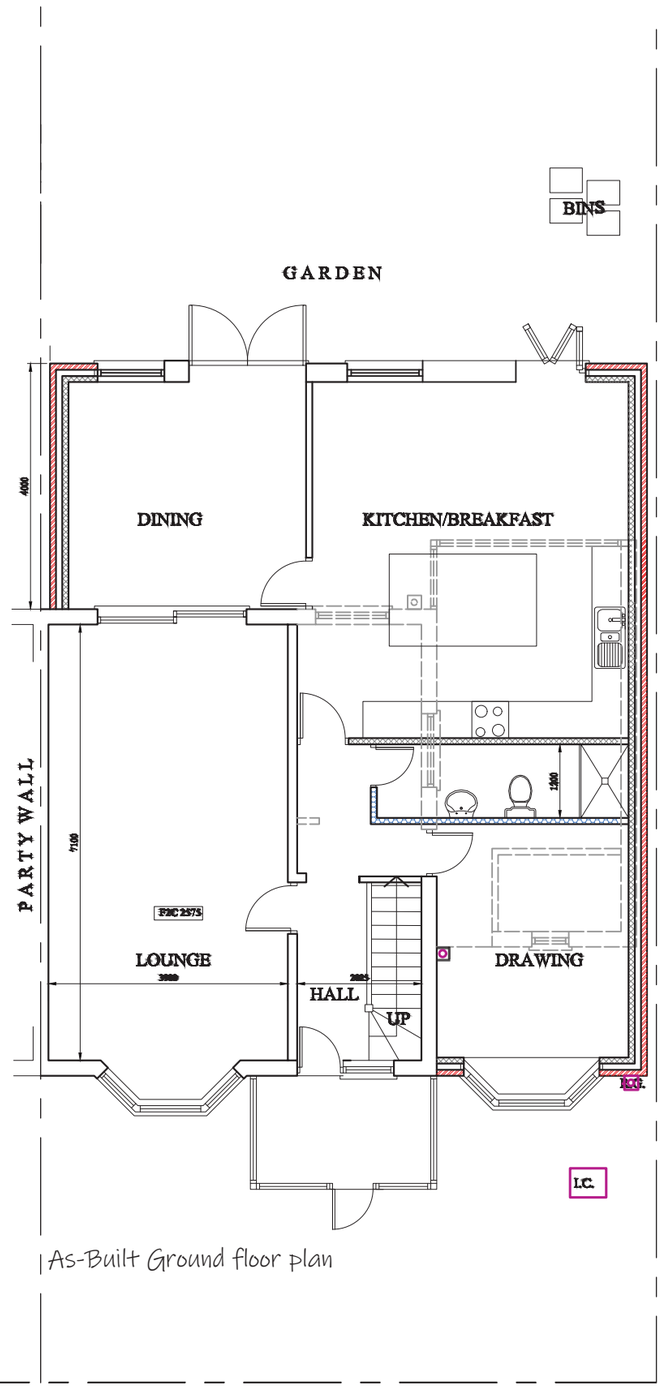

As-Built Ground floor plan

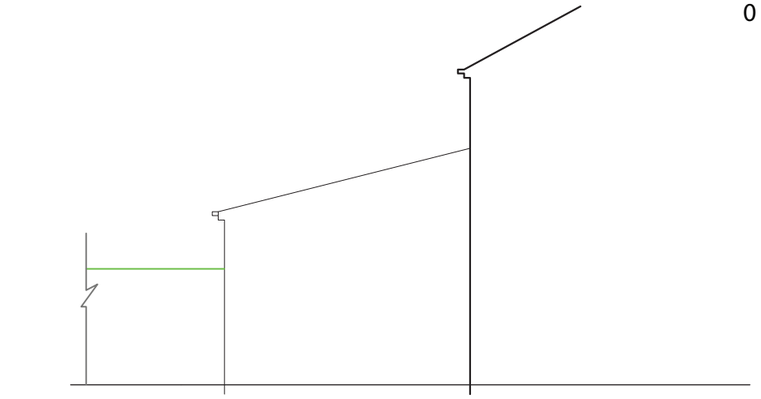


As Built side elevation

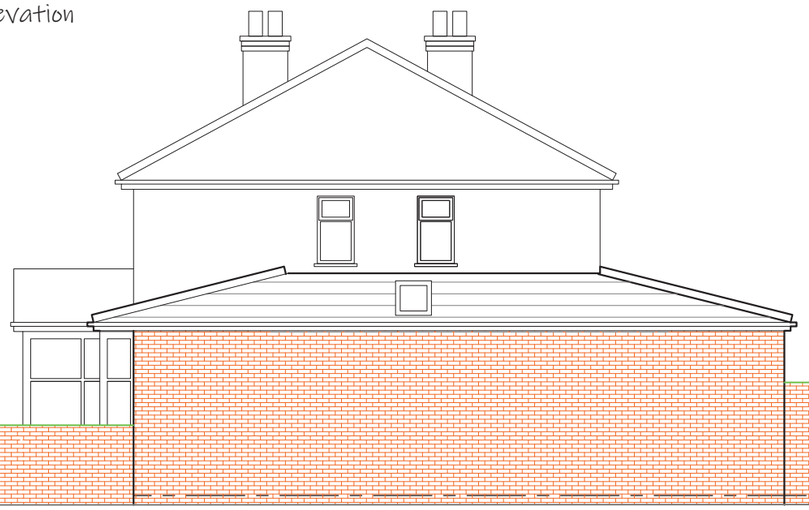


As Built side elevation

Boundary wall

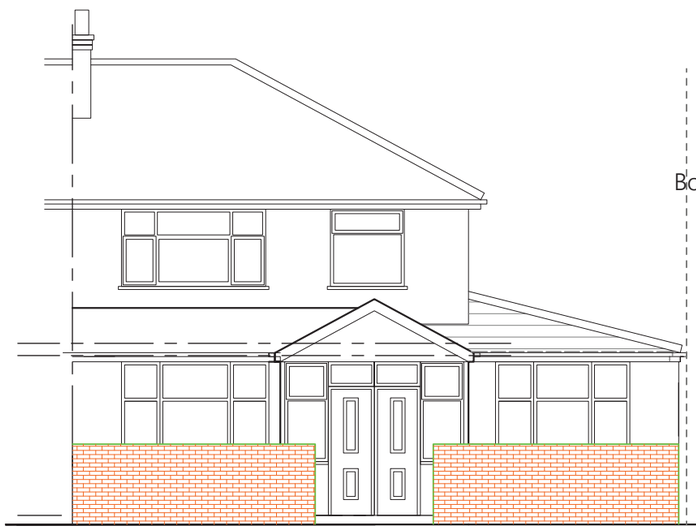

As-Built Front elevation of Boundary

Boundary wall

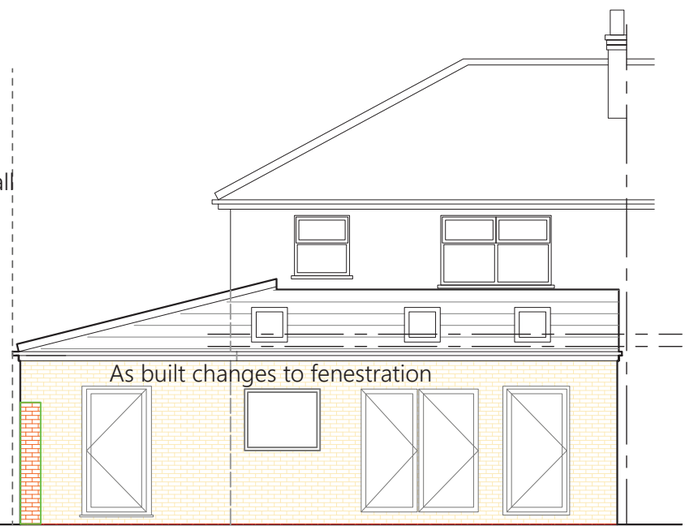

As-Built Rear elevation of Boundary