5m

SCALE

0 10m


Client: Mr Moniruz Zaman

Project: 194 Hamilton Rd
M13 0PX
Retrospective application for alterations to rear fenestration and modifications to the boundary wall

Approved plans and elevations
PP- 125694/FH/2019

Scale - 1:100


Do not scale from this drawing. All information should be checked by the contractor on site before commencing work. Any discreprencies should be reported to the designer immediately. All rights are reserved and are not transferable. Unathorised reproductions of this drawing are not permitted.

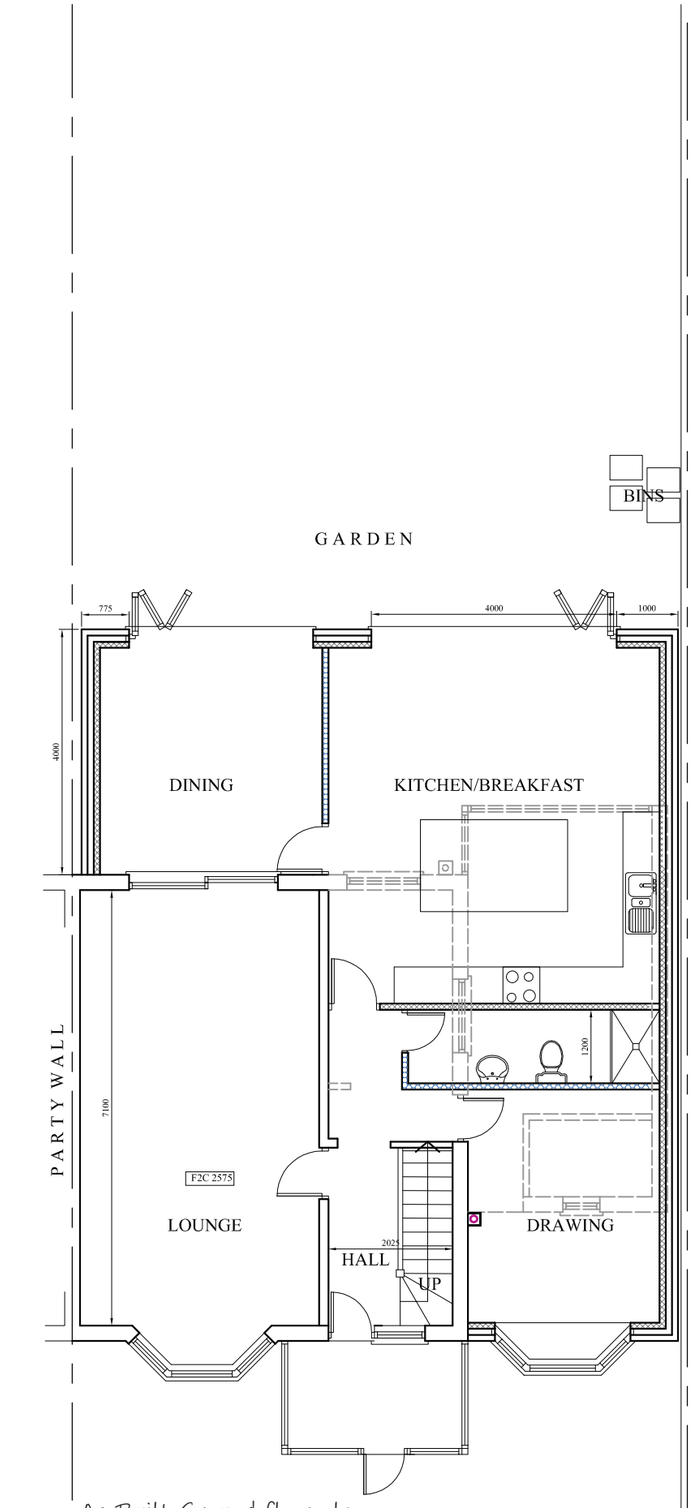


As-Built Ground floor plan




Approved front elevation

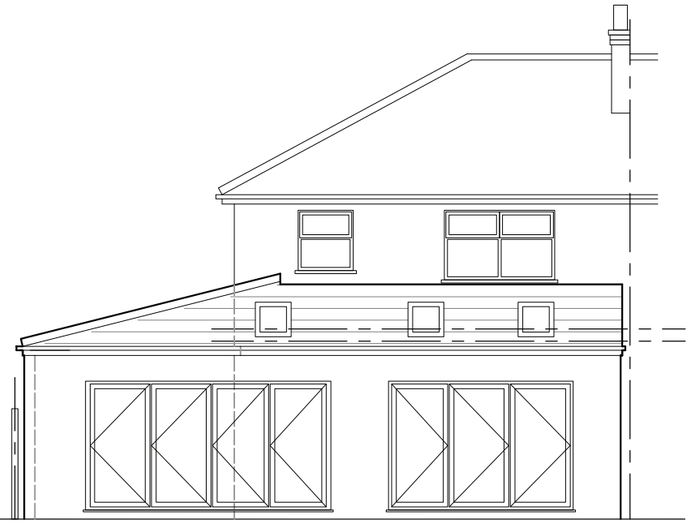

Approved rear elevation

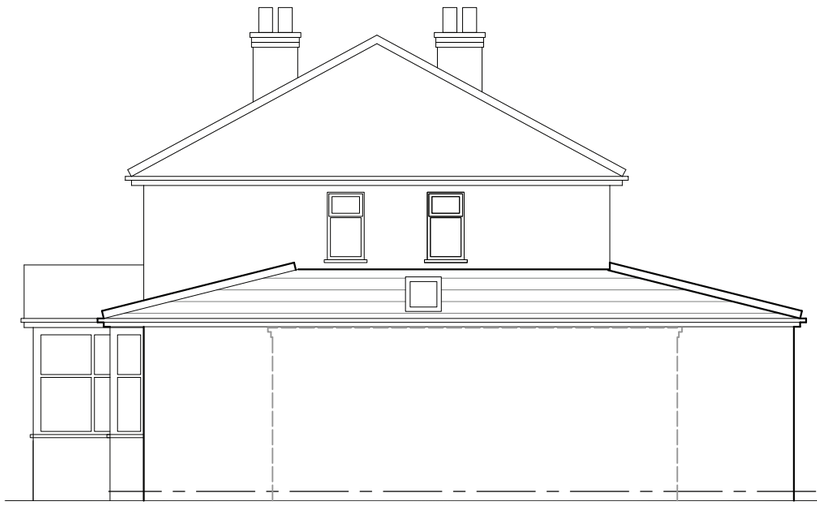

Proposed side elevation

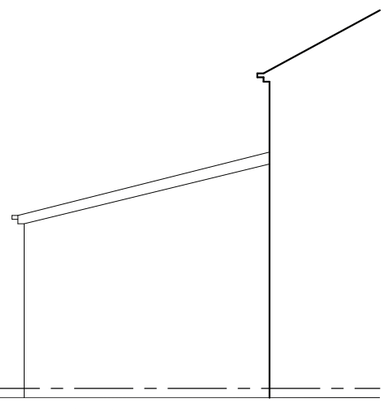

Proposed side elevation