
Client: Mr Moniruz Zaman

Project: 194 Hamilton Rd
M13 0PX
Retrospective application for alterations to rear fenestration and modifications to the boundary wall

Proposed Site Plan
Scale - 1:200

Do not scale from this drawing. All information should be checked by the contractor on site before commencing work. Any discreprencies should be reported to the designer immediately. All rights are reserved and are not transferable. Unathorised reproductions of this drawing are not permitted.

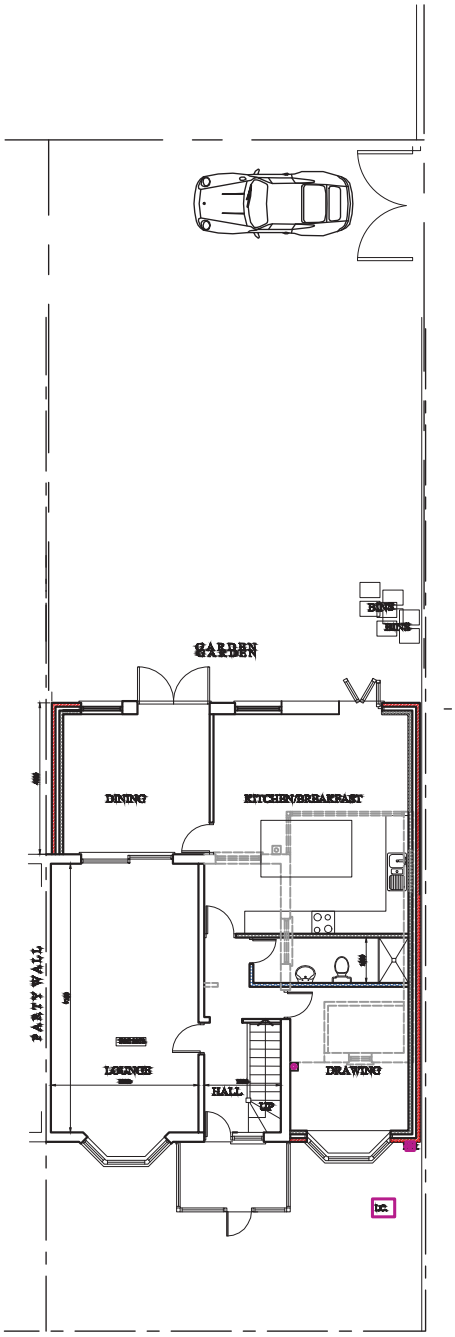

As Built Site plan

