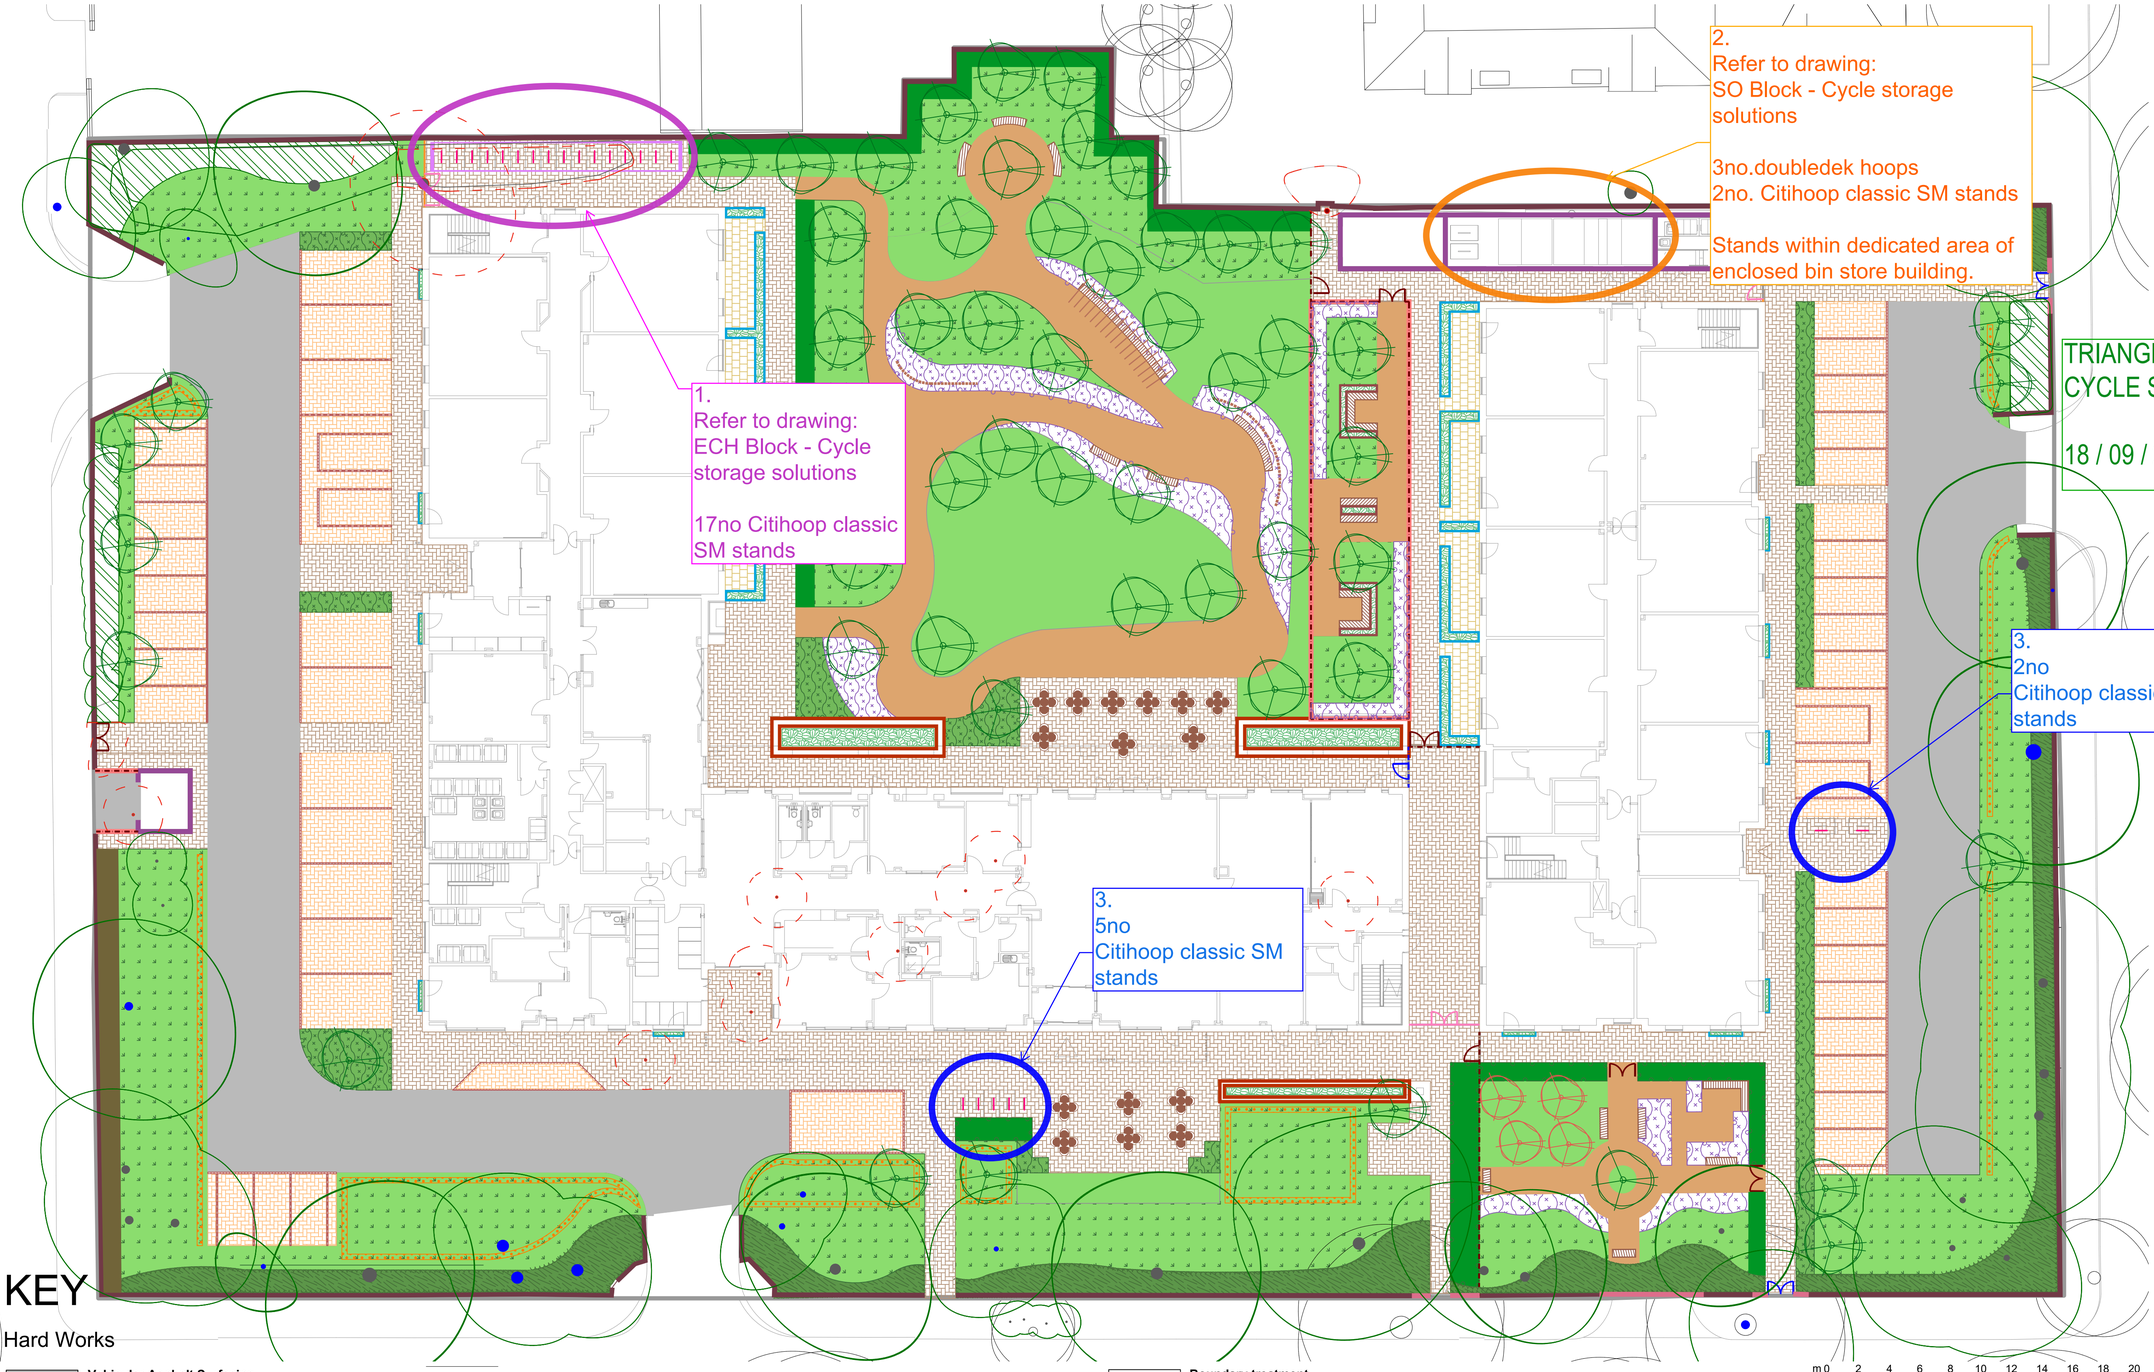


Do not scale this drawing (printed or electronic version).

Contractors must check all dimensions from site

This drawing is copyright and is for use on this site only. This drawing should be read in conjunction with all relevant consultants drawings and specialist subcontractors / supply chain drawings and specifications.

All works to be carried out in accordance with the latest British Standards / Codes of Practice unless specifically directed otherwise in the specification.

Responsibility for the reproduction of this drawing in paper form, or issued in electronic format, lies with the recipient to check that all information has been replicated in full and is correct when compared to the original paper or electronic image.

Graphical representations of equipment on this drawing have been co-ordinated, but are approximations only. Please refer to the specifications and / or details for actual sizes and / or specific contractor construction information.

Notes:-

Landscape proposals subject to co-ordination with the drainage strategy

TRIANGLE ARCHITECTS MARKUP - CYCLE STORAGE LOCATIONS

18 / 09 / 2026

REV.	DATE	DESCRIPTION	DRAWN	CHK'D
P09	26/03/26	Updated Layout	AG	SW
P08	25/06/25	Updated Layout	TH	SW
P07	16/07/24	Updated Layout	SW	SA
P06	12/07/24	Updated Layout	TH	SW
P05	12/07/24	Updated Layout	TH	RS
P04	09/07/24	Updated Layout	SA	SW
P03	26/06/24	Updated Layout	RS	SW
P02	14/05/24	Updated Layout	RS	SW
P01	27/02/24	FIRST ISSUE	IG	SW

U R B A N G R E E N

A: Ground Floor, The Tower, Deva City Office Park, Trinity Way, Manchester M3 7BF

T: +44 (0) 161 312 3131

weareurbangreen.co.uk

Client: GREAT PLACES HOUSING GROUP

Project: RUSSELL ROAD EXTRA CARE

Title: GENERAL ARRANGEMENT

Issue: PLANNING

Drawn:	Checked:	Approved:
IG	SW	SA
Project: UG2410	**Scale @ A1:** 1:200	**Date:** 27/02/24
Dwg No: UG_2410_LAN_GA_DRW_101		**Revision:** P09

KEY

Hard Works

Vehicular Asphalt Surfacing
To roads
Black colour.
To engineer specification & recommendation

Precast Concrete Permeable Block Paving
To permeable parking areas.
200x100x80mm, Arran Stone colour

Precast Concrete Block Paving
To pedestrian primary circulation.
208x173x60mm, Heather colour

Precast Concrete Flag Paving
To private paths and patios
600 x 600 x 50mm, Oat colour

Precast Concrete Sett Paving
To parking space markings
Innis Black colour

Permeable Self Binding Gravel Surfacing
To pathways
Golden Amber colour.

Existing Brick Walls, some with railings
To be retained and repaired / replaced / infilled where necessary

Brick Walls, some with railings
To match existing

Low Brick Walls with Metal Railings
1200mm high total, with matching pillars
Brick colour to match architecture.

Bin Store / Sub Station Walls
1800mm high
Brick colour to match architecture.

Metal Railings and Gates
1200mm high. Metal.

Railings
1800mm high. Metal vertical bar.
With matching gates.

Railings and Gates
2100mm high. Metal vertical bar.
With matching gates.

Brick Wall and Gates
2100mm high brick wall with 2.1m high metal gates.

Timber Posts
Square: 91x91mm
Varying heights

Timber Benches
Specification to be confirmed.

Timber Planters
Specification to be confirmed.

Brick Planters
Coping as seating
Specification to be confirmed.

PCC Aliminium Planters
Specification to be confirmed.

Cycle Shelter
Specification to be confirmed.

Timber Pergola Shelter
Specification to be confirmed.

Boundary treatment
To architect specification & recommendation

Cycle Stands
To manufacturer's specification

Soft Works

Existing Tree - Retained
To be retained - refer to arboricultural drawings
Prunning recommended to minimum of 2400mm from the ground

Existing Tree - Removed
To be removed - refer to arboricultural drawings

Proposed Standard Tree Planting
Native and ornamental species

Proposed Fruit Tree Planting
Select standard

Existing Hedge / Vegetation
To be retained

Species Rich Native Hedge Planting
Native species mix

Proposed Ornamental Hedge Planting
Ornamental shrub

Proposed Groundcover Planting
Ornamental species mix.

Proposed Ornamental Shrub Planting
Ornamental shrub mix.
Maintained to maximum 1000mm high

Proposed Native Shrub Planting
Native shrub mix.

Proposed Sensory Mixed Planting
Herbaceous/ grass perennial & shrub mix.

Proposed Seasonal Bulb Planting
Native bulb mix.

Proposed Turf Grass
To amenity spaces and front gardens.

Proposed Wildflower Meadow
Species rich grass & wildflower seed mix.

m 0 2 4 6 8 10 12 14 16 18 20
SCALE
1:200