
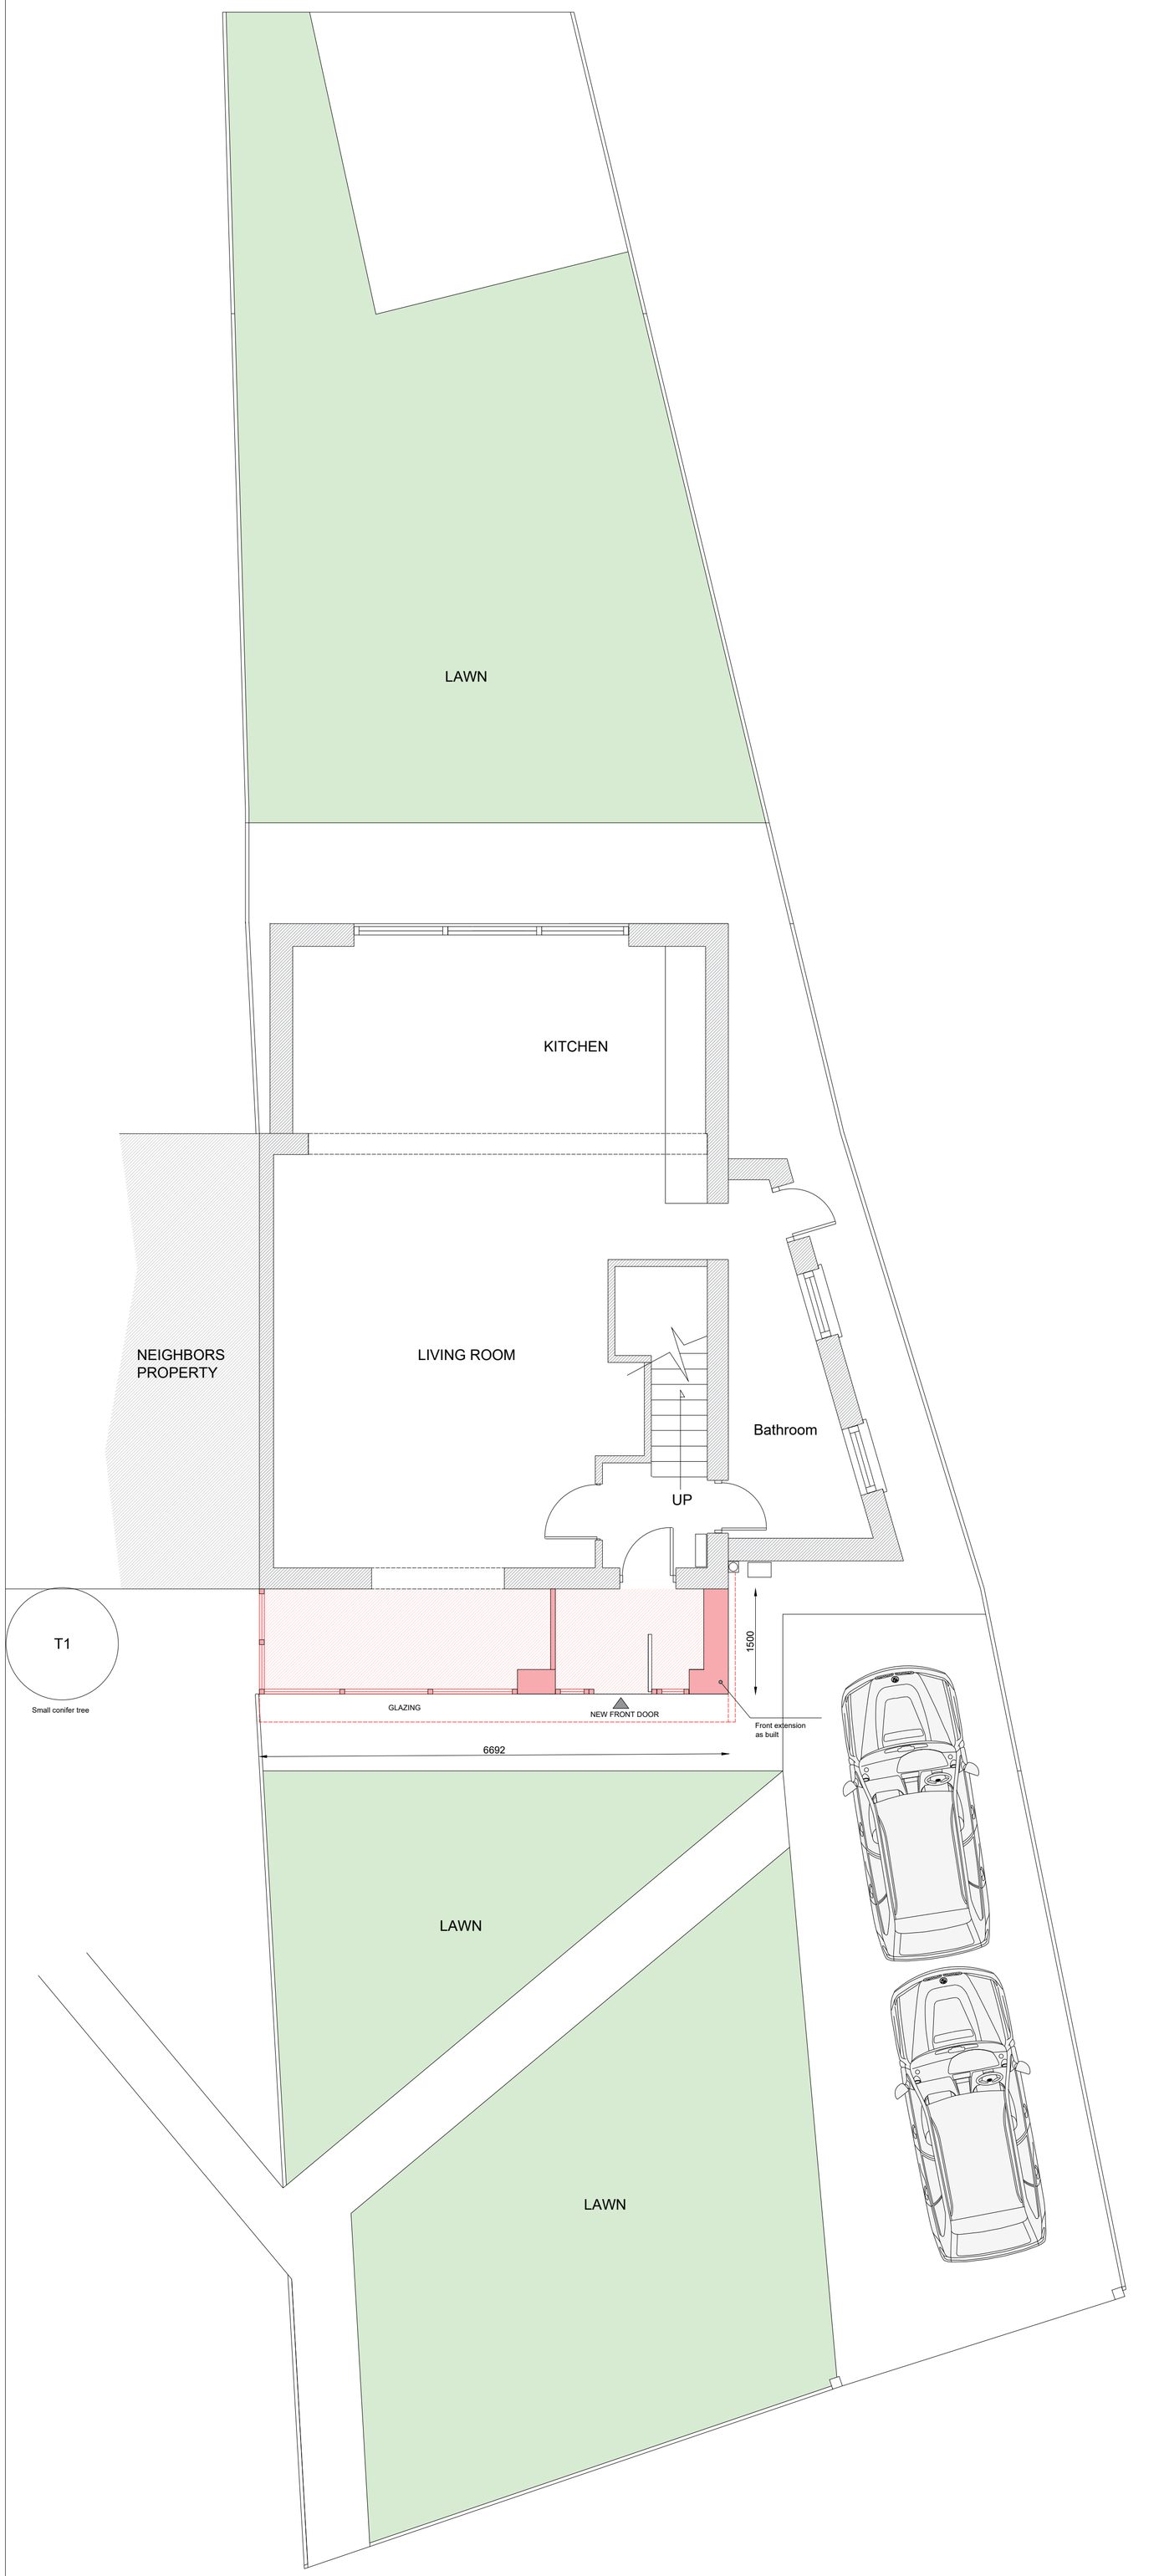


EXISTING GROUND FLOOR PLAN AS BUILT

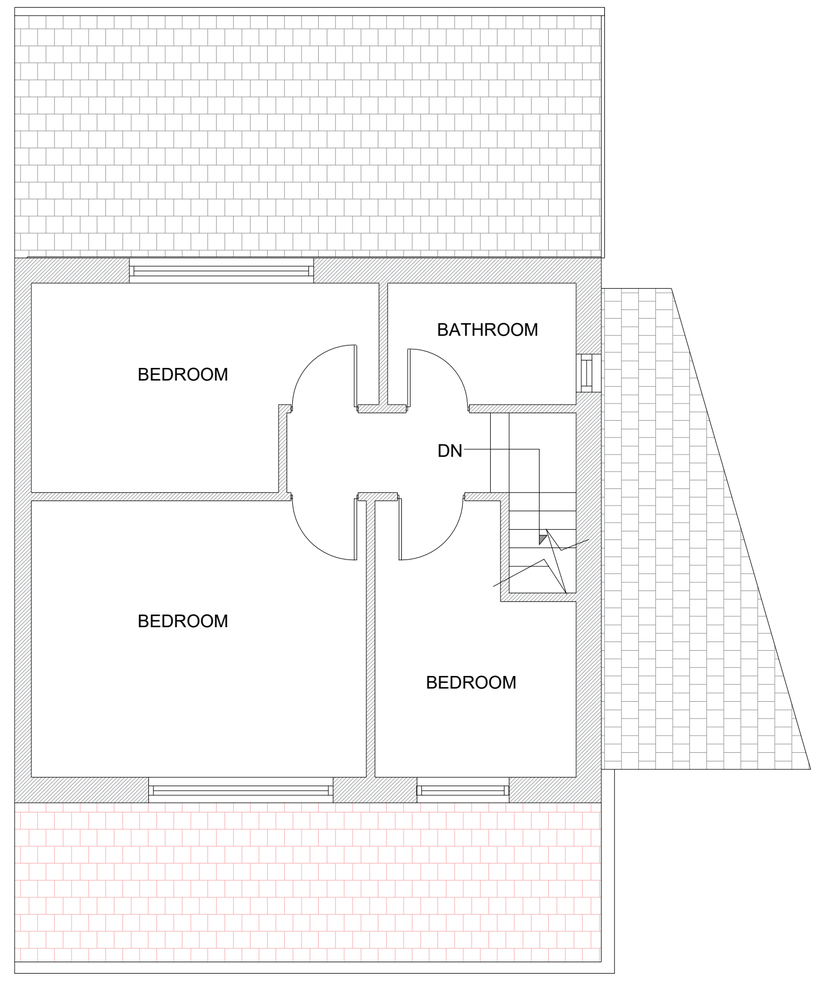

EXISTING FIRST FLOOR PLAN AS BUILT

0 1m 2m 3m 4m 5m

Project:

Retrospective planning application for front extension at:


3 Alston Gardens
Manchester
M19 1DW

Client: Mrs Layla Mahmood

DRG Title:
Proposed Plans

	Job No	Dwg. No
Date: 19/10/2026	19.10.00	02
Scale: 1:50 on A1		


Email: SUNBULL1@HOTMAIL.CO.UK
Tel: 07587719118

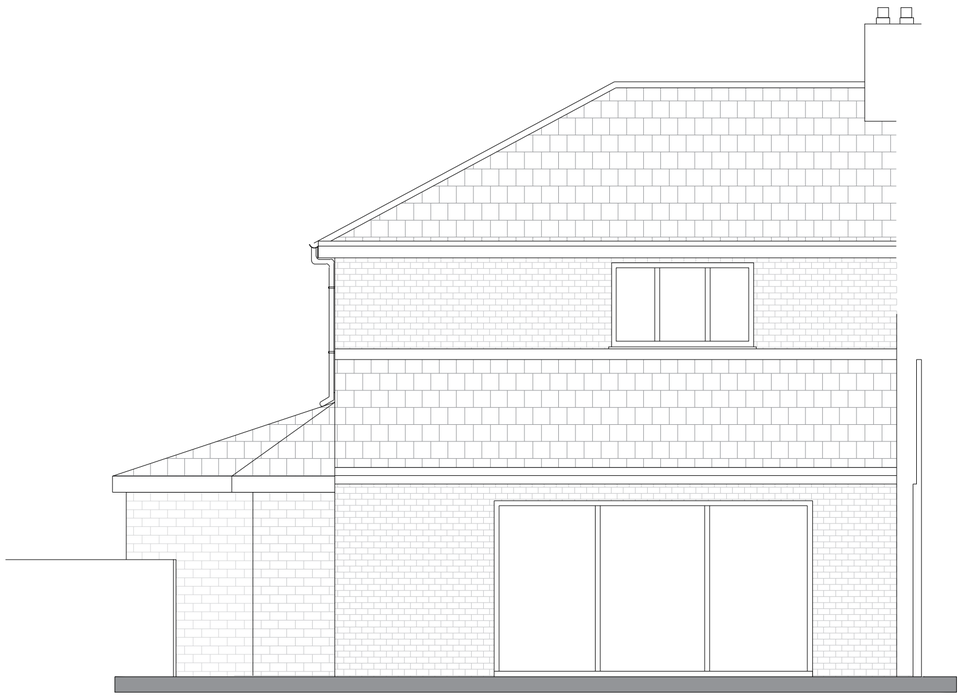


EXISTING REAR ELEVATION AS BUILT



EXISTING FRONT ELEVATION AS BUILT

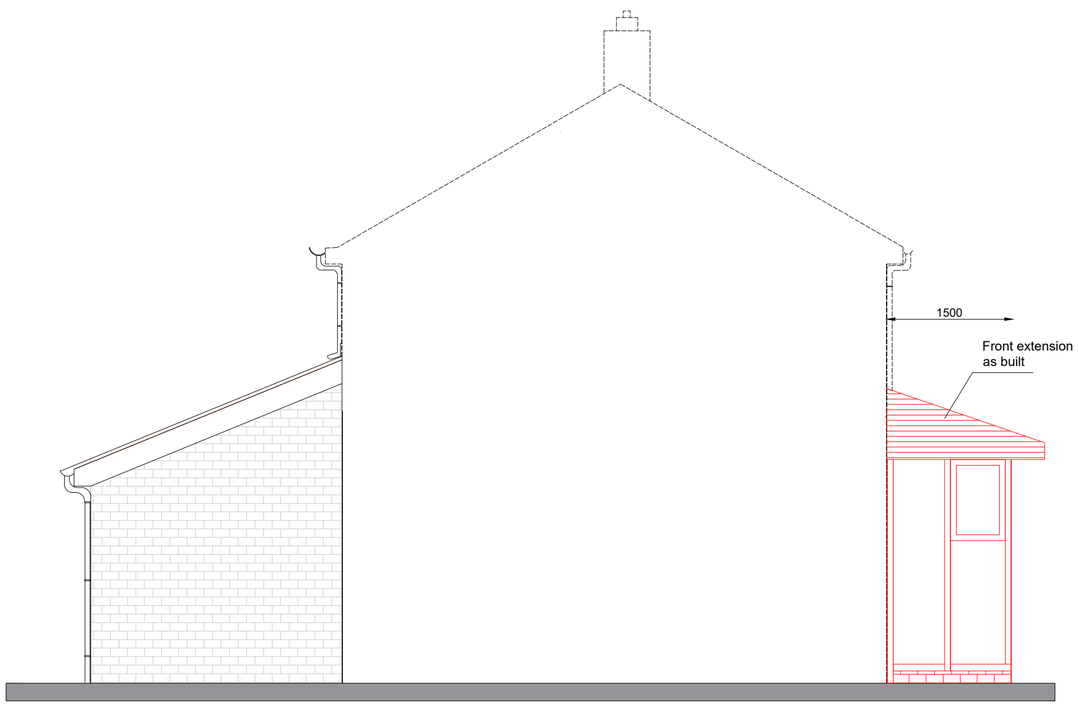

EXISTING SIDE ELEVATION AS BUILT

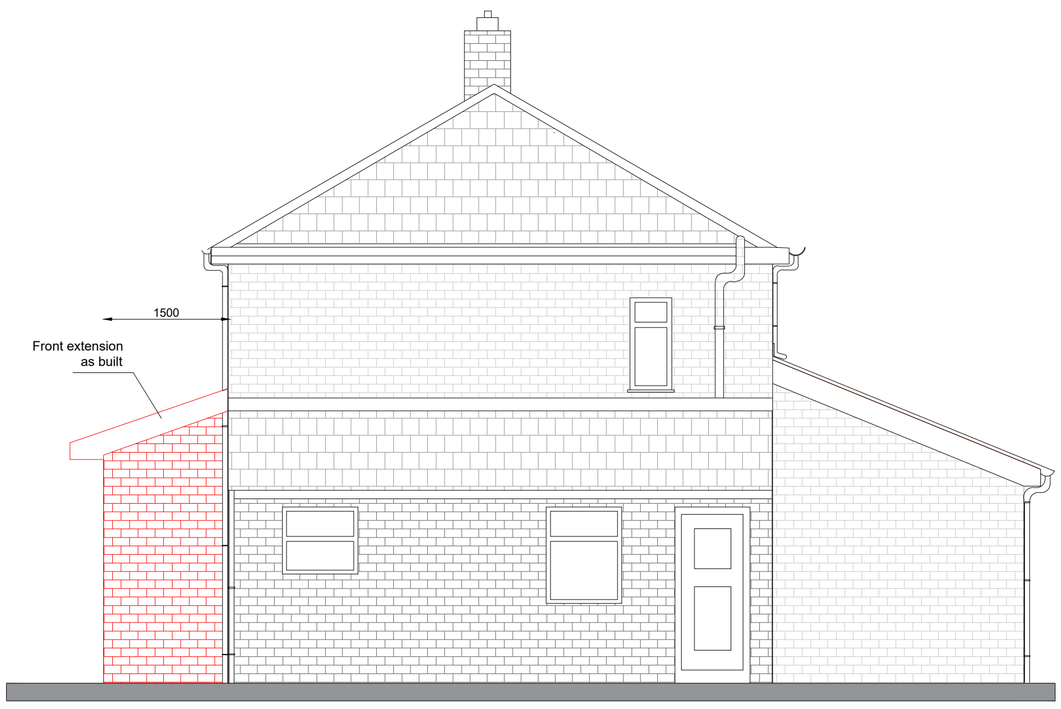

EXISTING SIDE ELEVATION AS BUILT



Project:

Retrospective planning application for front extension at:


3 Alston Gardens
Manchester
M19 1DW

Client: Mrs Layla Mahmood

DRG Title:

Proposed Plans

	Job No	Dwg. No
Date: 19/10/2026	19.10.00	03
Scale: 1:50 on A1		

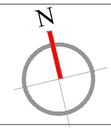

Email: SUNBULLI@HOTMAIL.CO.UK
Tel: 07587719118