

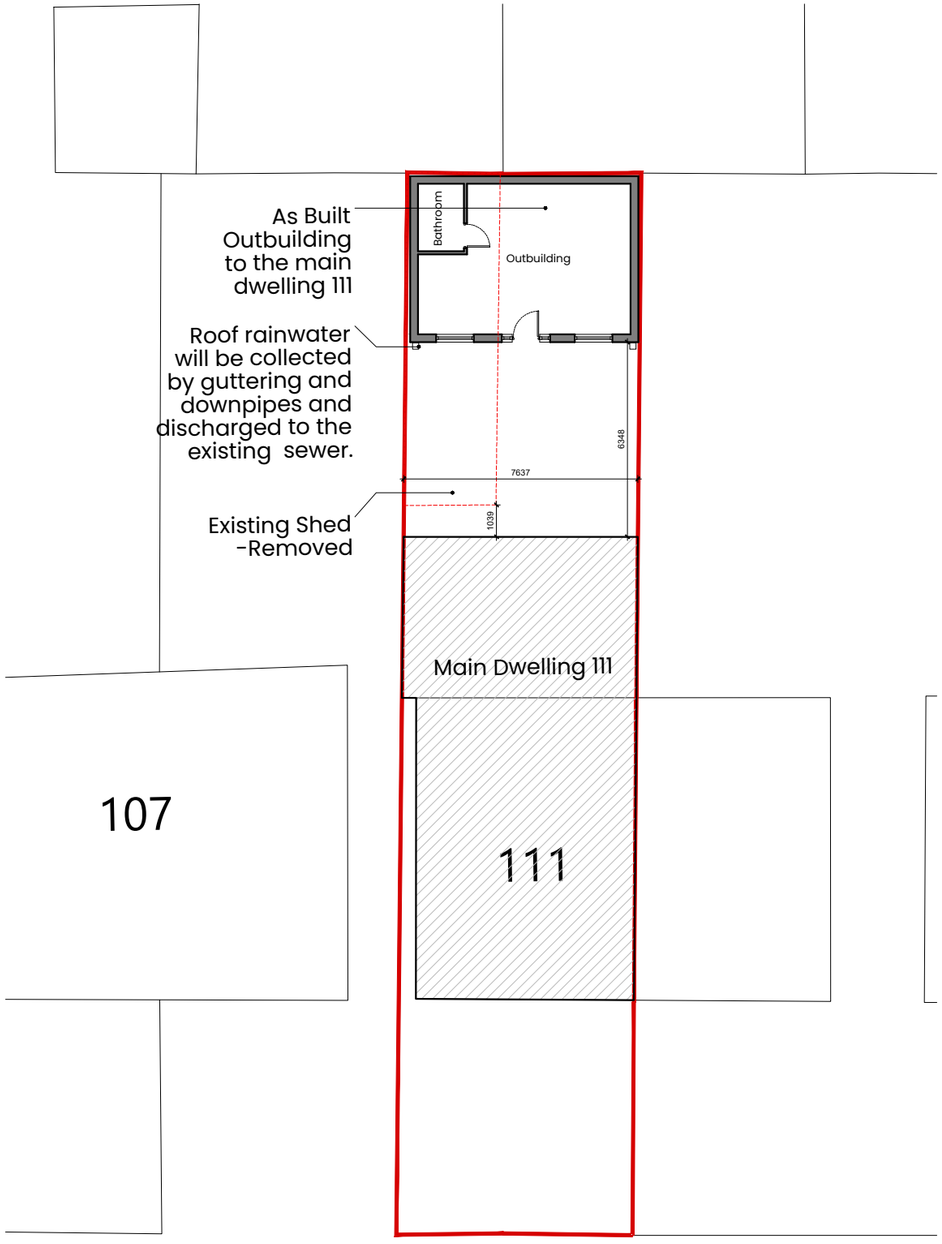



01 As Built Site Plan
Scale 1:200 @ A3

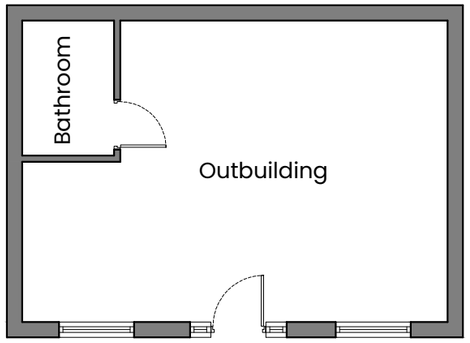


02 As Built Ground Floor Plan
Scale 1:100 @ A3

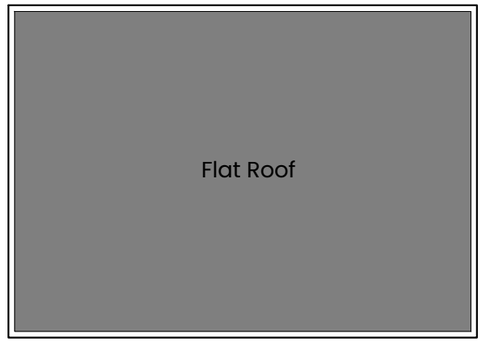


03 As Built Roof Plan
Scale 1:100 @ A3

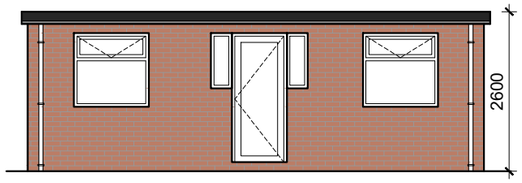


04 As Built Front Elevation
Scale 1:100 @ A3

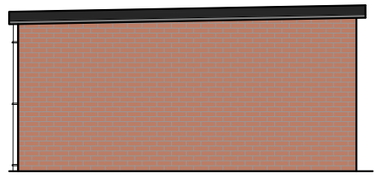

05 As Built Side Elevation
Scale 1:100 @ A3

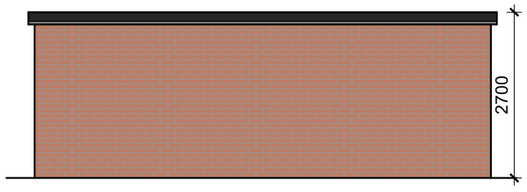

06 As Built Rear Elevation
Scale 1:100 @ A3

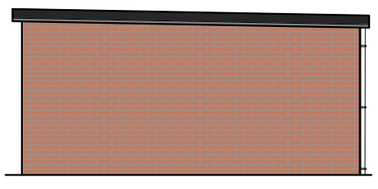

07 As Built Side Elevation
Scale 1:100 @ A3

N

Element Key

Site Boundary

0 4 8 12

SCALE BAR 1:200

0 2 5

SCALE BAR 1:100

General Notes:

All site dimensions shall be verified by the Contractor on site prior to commencing any works.

Design intent drawing only. Construction to comply with latest building regulation requirements.

This drawing is the property of "Studio Tashkeel Architecture Ltd." and copyright is reserved by them. The drawing is not to be copied or disclosed by or to any unauthorised persons without the prior written consent of Studio Tashkeel Architecture Ltd.

Rev	Description	Date	Dr by	App by
-	First Issue	11.10.2026	HP	MK

STUDIO TASHKEEL
ARCHITECTURE LTD.
1-3 Ashton Lane, Sale M33 6WT
Manchester, United Kingdom

T +44(0)161 546 5395
E info@StudioTashkeel.com
www.studiotashkeel.com

client name	Golum Reza Pakbin
project	111 Kingsway, Manchester M19 2LN
drawing	As Built Site Plan ,Floor Plan & Elevations

project number	**rev**	**scale**
6148		1:100 @ A3
drawing number	**rev**	**issue status**
STA6148PL02	-	Planning

This drawing is to be read in conjunction with all related drawings. All dimensions must be checked and verified on site before commencing any work or producing shop drawings.The originator should be notified immediately of any discrepancy. This drawing is copyright and remains the property of Studio Tashkeel Architecture Ltd.